

OIPE  
 DEC 26 2002  
 PATENT & TRADEMARK OFFICE

Approved  
 HAB

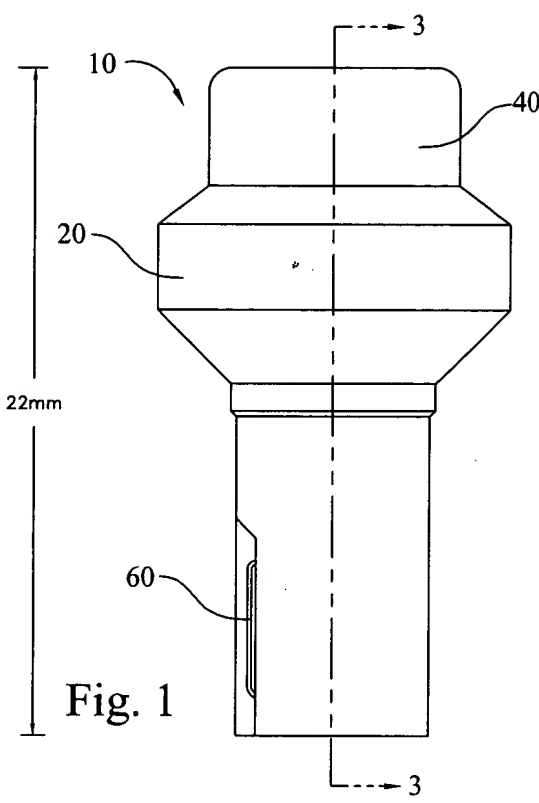


Fig. 1

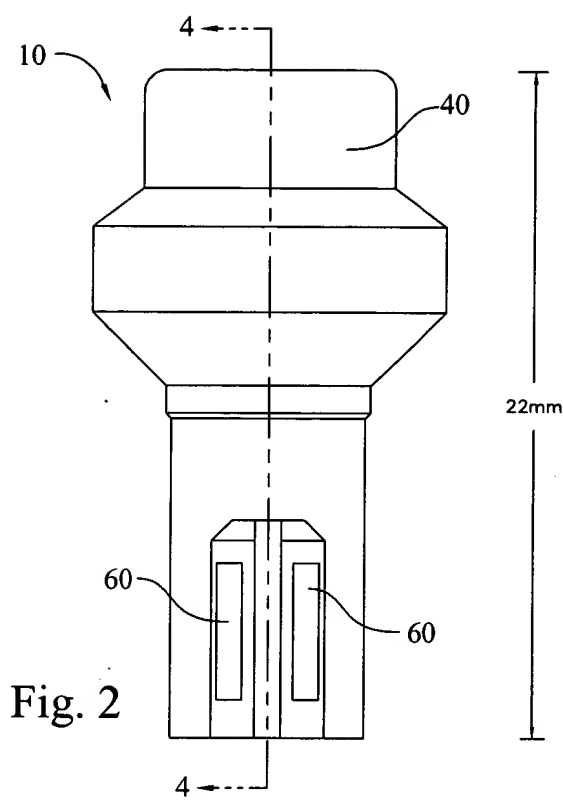


Fig. 2

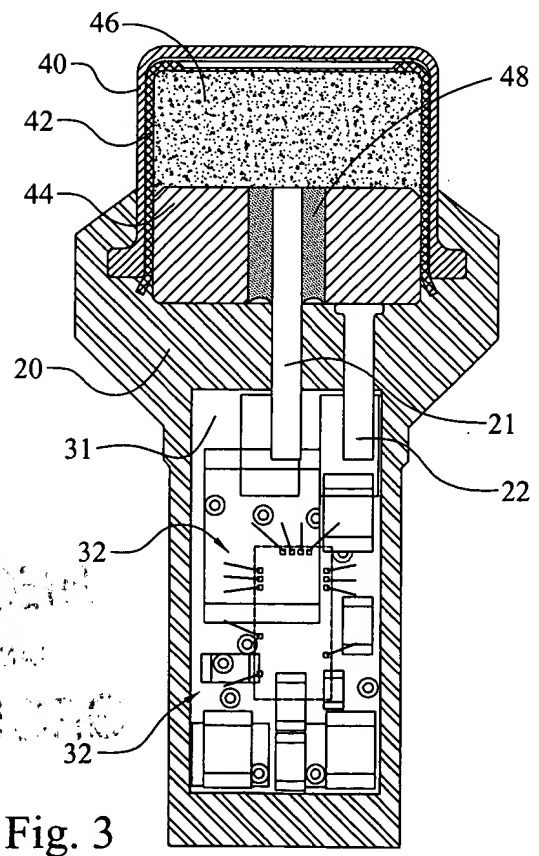


Fig. 3

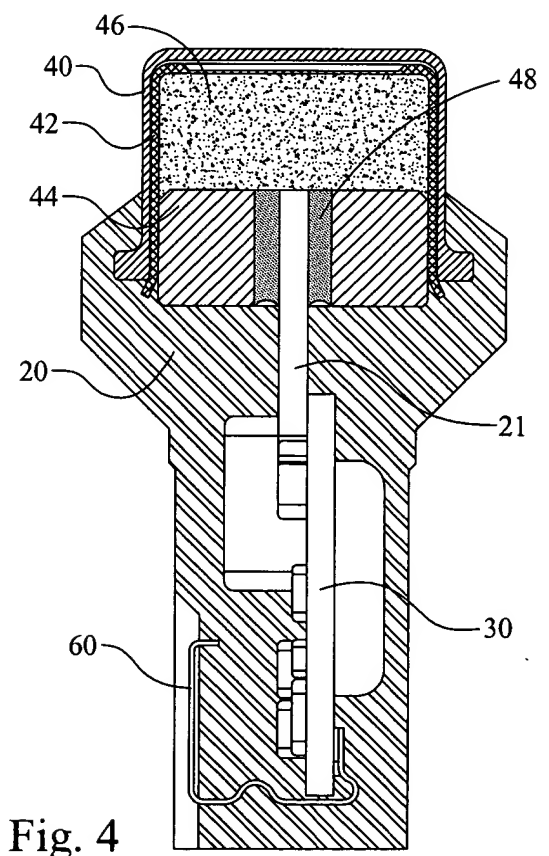


Fig. 4

RECEIVED  
 OIPE  
 DEC 26 2002

11:48 FAX

0002

redlined version

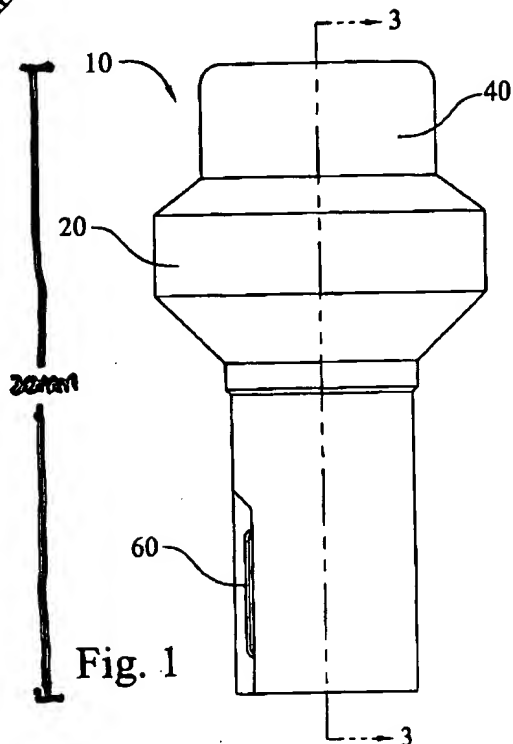
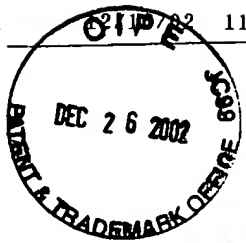


Fig. 1

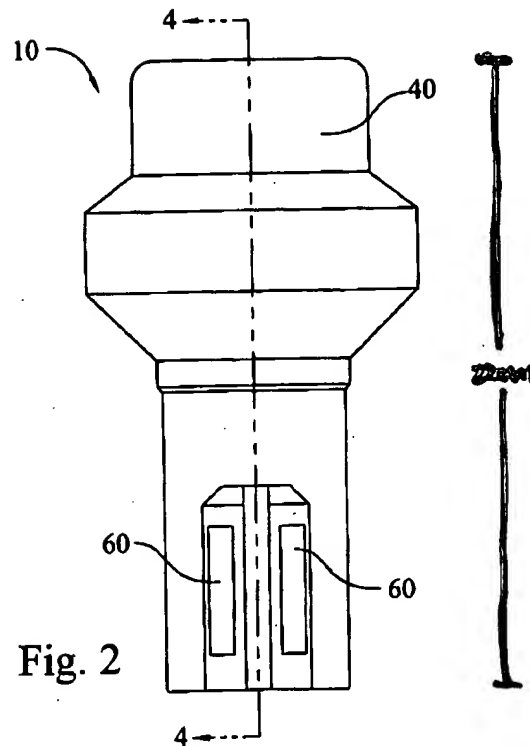


Fig. 2

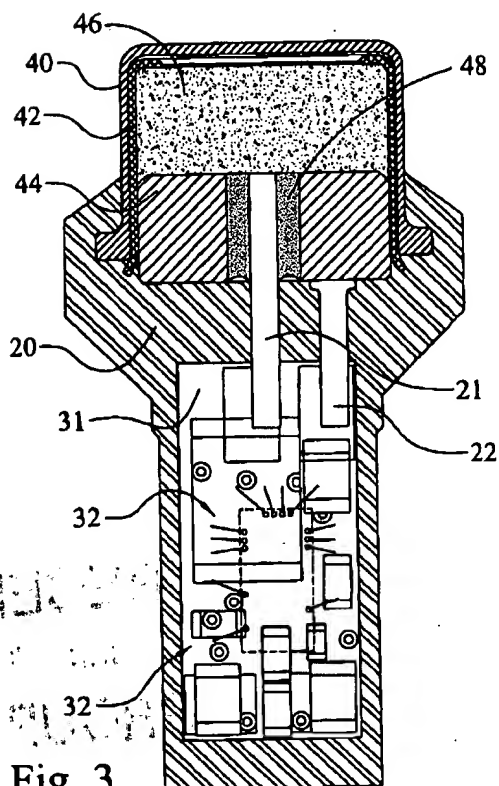


Fig. 3

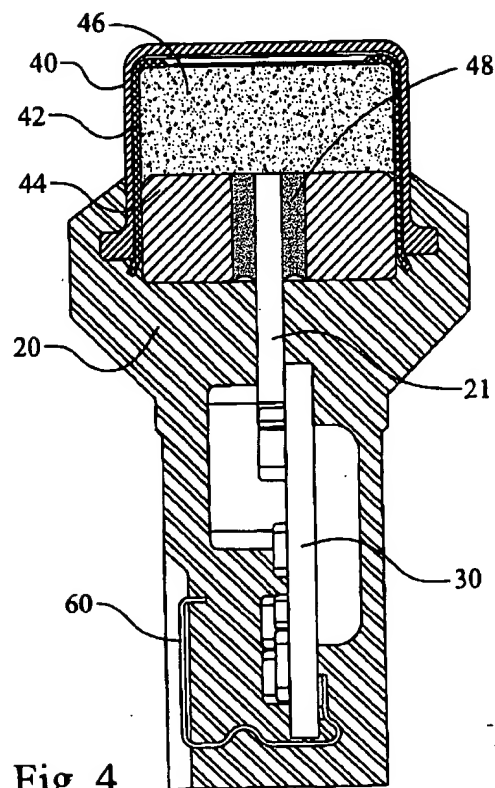


Fig. 4

Approved  
HAB